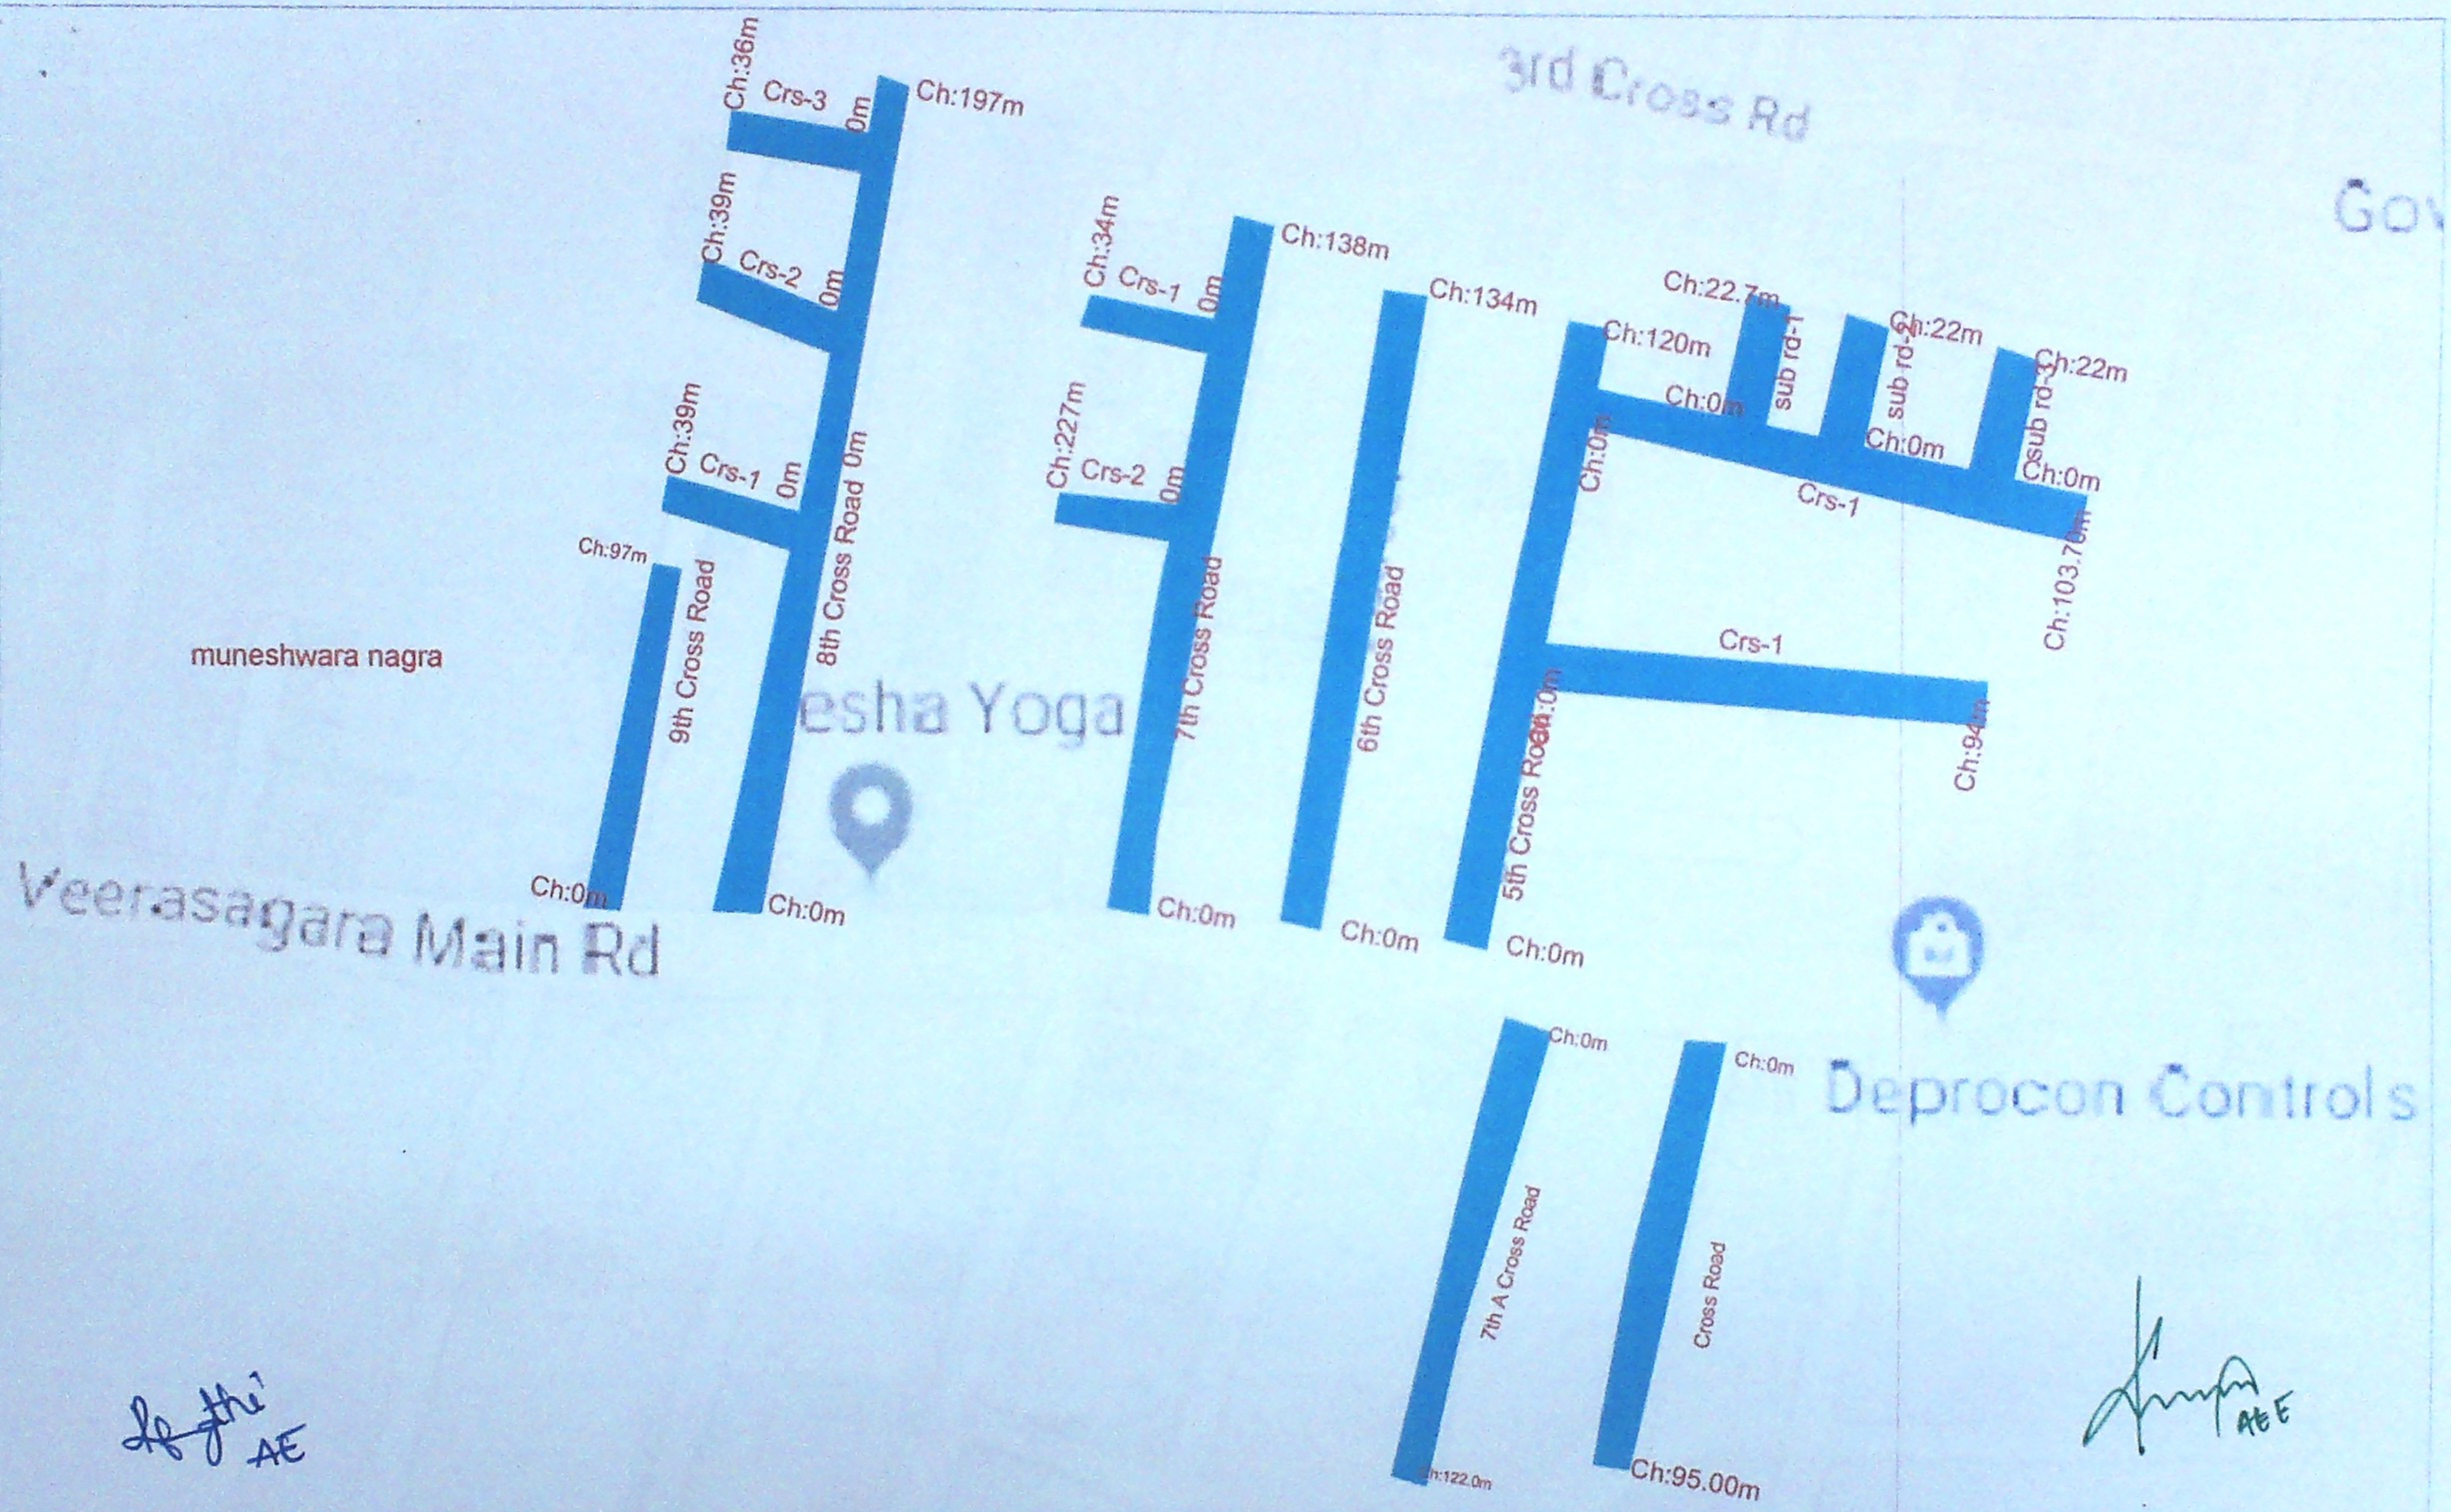

CLIENT: **BRUHAT BANGALORE MAHANAGARA PALIKE**	PACKAGE-1	Dwg Title: As Built plan Dwg no:
		scale; N.T.S Date Rev: R0

Design and Technology

elahanka 5th
Phase Park

Shiva Mandir Rd

2nd Cross Rd

Shiva Mandir Rd

Manasa Trinity
Heart Hospital

Ch:0m

ICICI Bank
Yelahanka, Bangalore...

Ch:295m

4th main road

Ch:82.7m

SFS 707

Ch:82m

Ch:0m

2nd cross road

Ch:0m

Central Bank
Of India ATM

Maharashtra

4th Phase Park

4th Cross Rd

4th A Main

Ch:144m

Ch:32m

Ch:0m

Ch:0m

6th Main Rd

Main Rd

Ch:0m

RETAIL ASSETS HUB ROAD

Navach

Kendriya Vidyalaya
RWF yelahanka

Ch:361m

Asphalt Road

Concrete Road

CLIENT: BRUHAT BANGALORE MAHANAGARA PALIKE	PACKAGE-1	Dwg Title: As Built plan	scale: N.T.S
			Date
		Dwg no:	Rev: R0

Yelahanka

Bank Of Maharashtra

4th Cross Rd

7th Crs road

Ch:0m

Ch:133.0m

Ch:321m

Swamy Vivekananda Park

4th Phase

SFS 407

6th Cross Rd

Ch:279m

Ch:240m

Ch:204m

Ch:182m

32.50m

0m

2nd B main Road

crs road-1

crs road-2

6.80m

0m

2nd main Road (shivramkaranth road)

39.0m

0m

Crs road-1

Ch:0m

Ch:0m

Ch:0m

3rd main Road

Link Road

1st A main Road (shivarudrappa road)

1st B main Road (Kuvempu road)

Ch:0m

Ch:0m

Ch:0m

Ch:0m

3A Crs beside

Ch:33.70m

3A Crs Rd

Ch:0m

Ch:0m

Ch:40m

cross road

Ch:0m

Ch:208m

Ch:0m

Ch:35m

Ch:327m

2nd Main Road

3rd main Rd

1st Crs rd

Ch:0m

Ch:33.0m

Ch:71m

1st main Road

Ch:0m

1st Main Road

SFS 208

SFS 208

4th Phase

Ch:0m

Ch:288m

2nd Main Road

Ch:35.70m

Ch:0m

cross road

Park road

Ch:0m

Ch:33.50m

Asphalt Road

Concrete Road

AE

CLIENT: BRUHAT BANGALORE MAHANAGARA PALIKE	PACKAGE-1	Dwg Title: As Built plan	Scale: N.T.S
			Date
		Dwg no:	Rev: R0

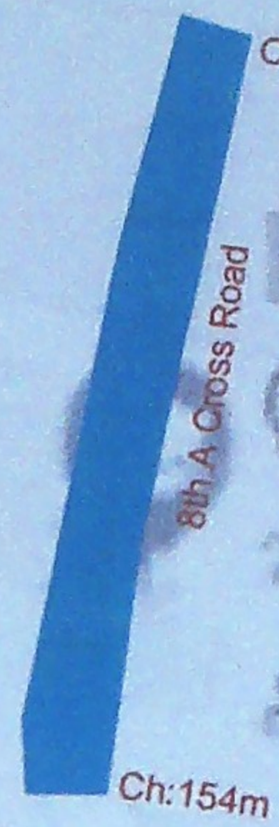

muneshwara nagra

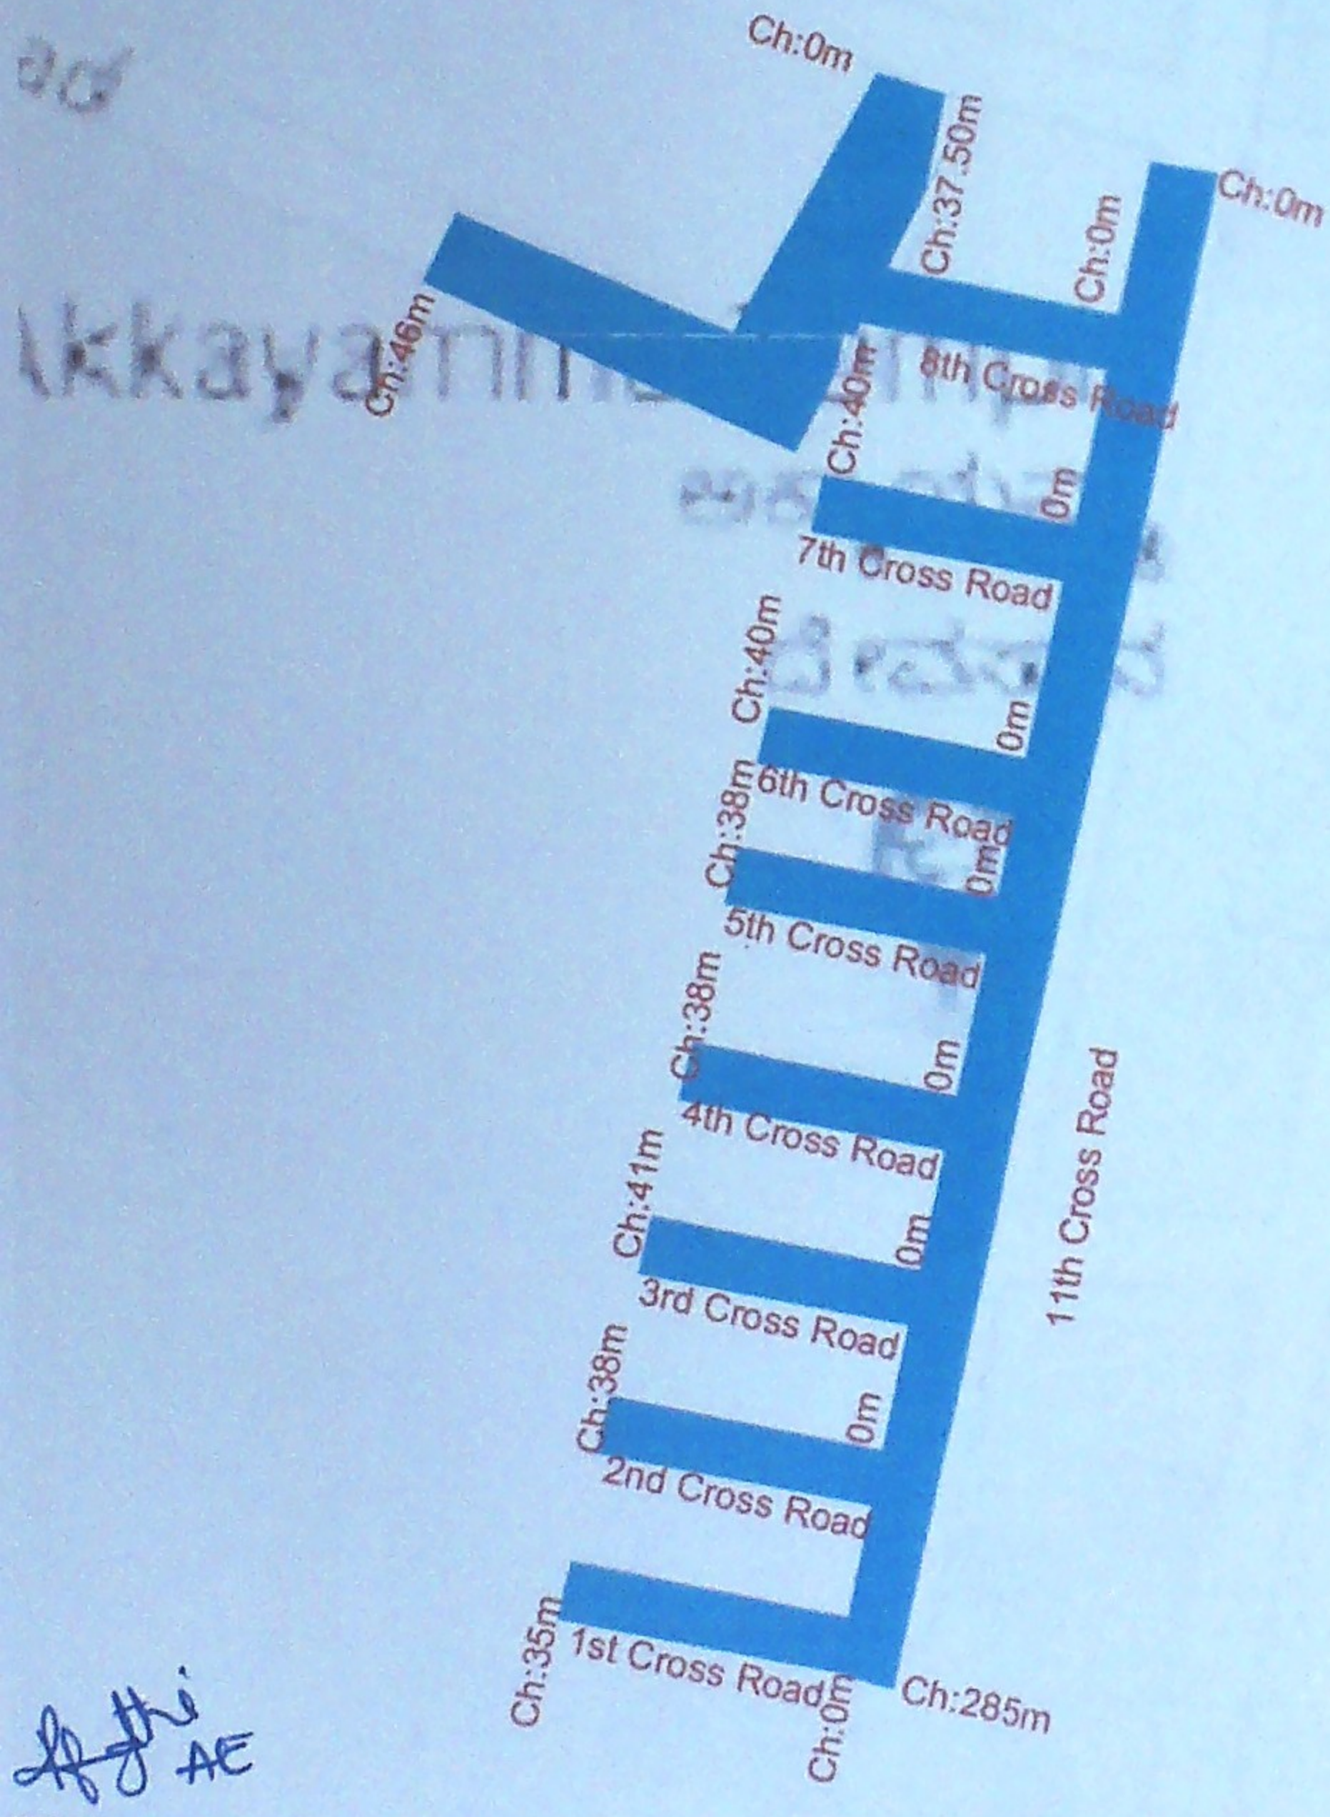

Sri Muneshwar
Swami Temple

Asphalt Road

Concrete Road

LIENT: RUHAT BANGALORE MAHANAGARA PALIKE	PACKAGE-1	Dwg Title: As Built plan	scale; N.T.S
			Date
		Dwg no:	Rev; R0

HDFC Life

State Bank of India Yelahanka New...

Ch:0m — 4th A cross road — Ch:84.42m — Cross Rd

5th cross road

Ch:0m — 1st main 1st cross road — Ch:3m — 2nd A Main Road

3rd Main Rd

4th A Main Rd

5th Main Road

Netaji Park

12th A Main Rd

IDBI Bank

Ch:0m — 1st main 7th cross road — Ch:133m

EuroKids

Shree Raghavendra Swamy Mutt

8th A Cross Rd

8th A Cross Rd

8th A Cross Rd

Asphalt Road

Concrete Road

CLIENT: BRUHAT BANGALORE MAHANAGARA PALIKE	PACKAGE-1	Dwg Title: As Built plan	scale; N.T.S
			Date
		Dwg no:	

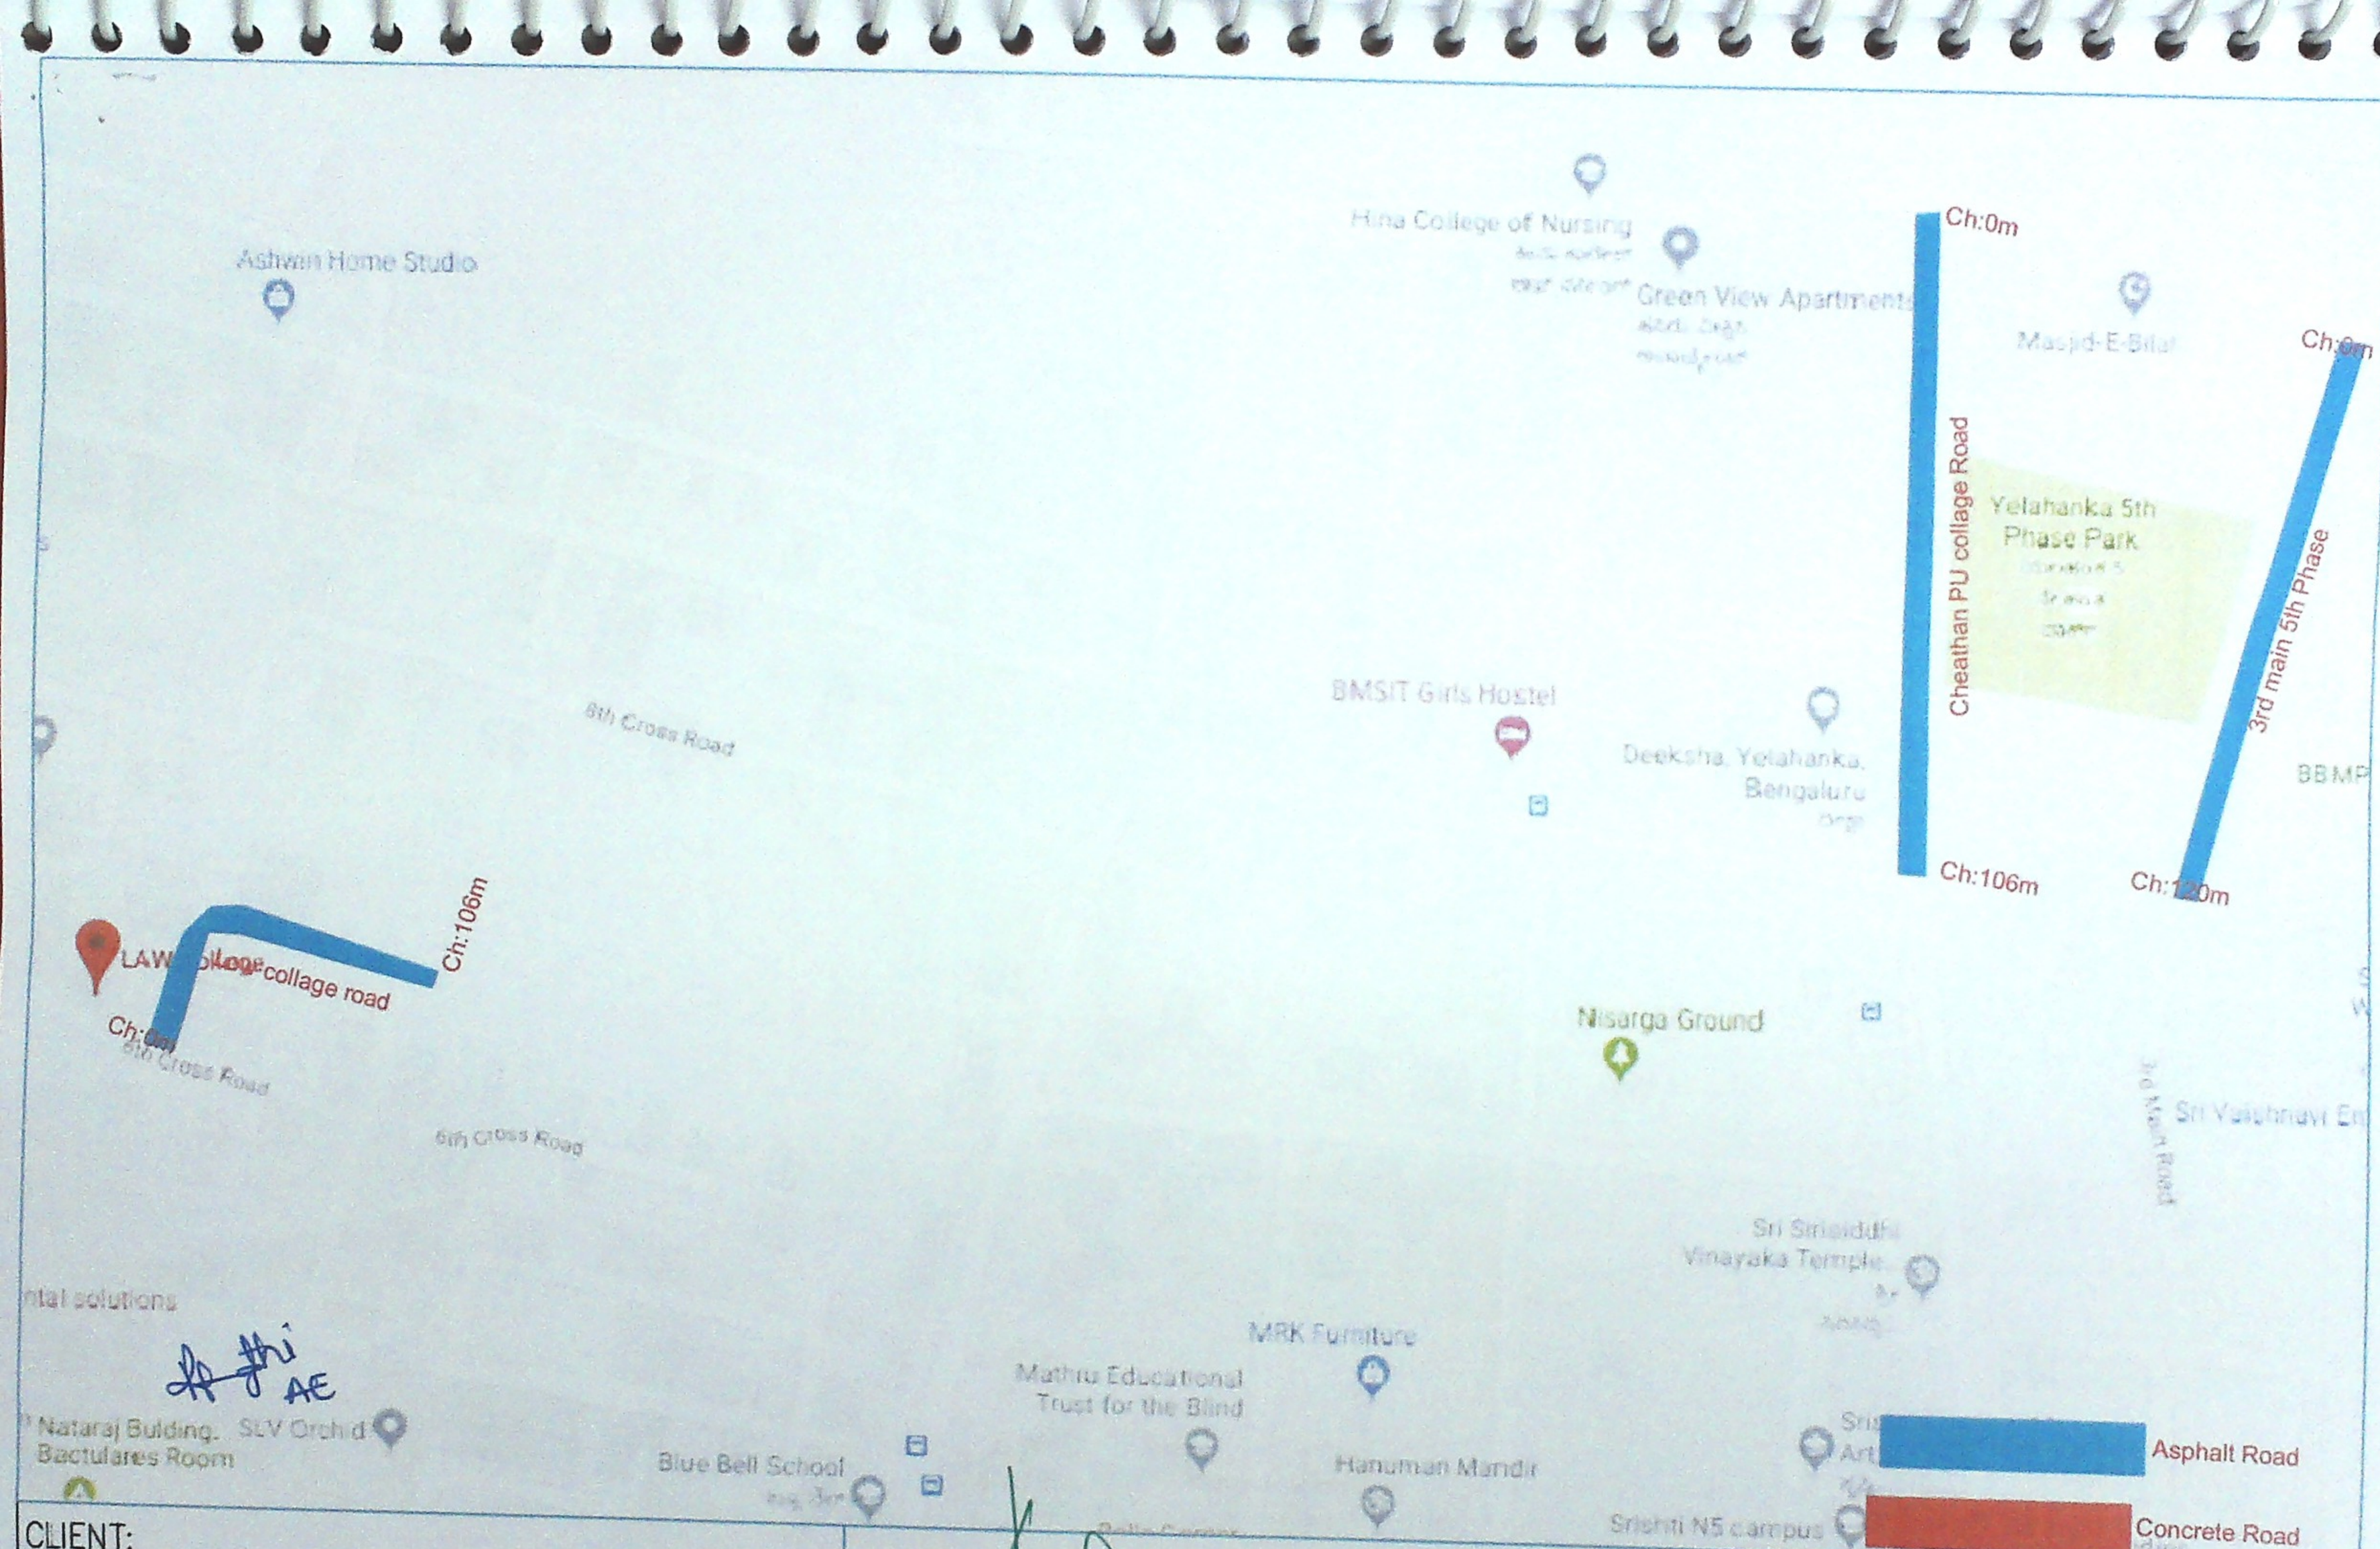

CLIENT: BRUHAT BANGALORE MAHANAGARA PALIKE	PACKAGE-1	Dwg Title: As Built plan Dwg no:
		Scale; N.T.S Date

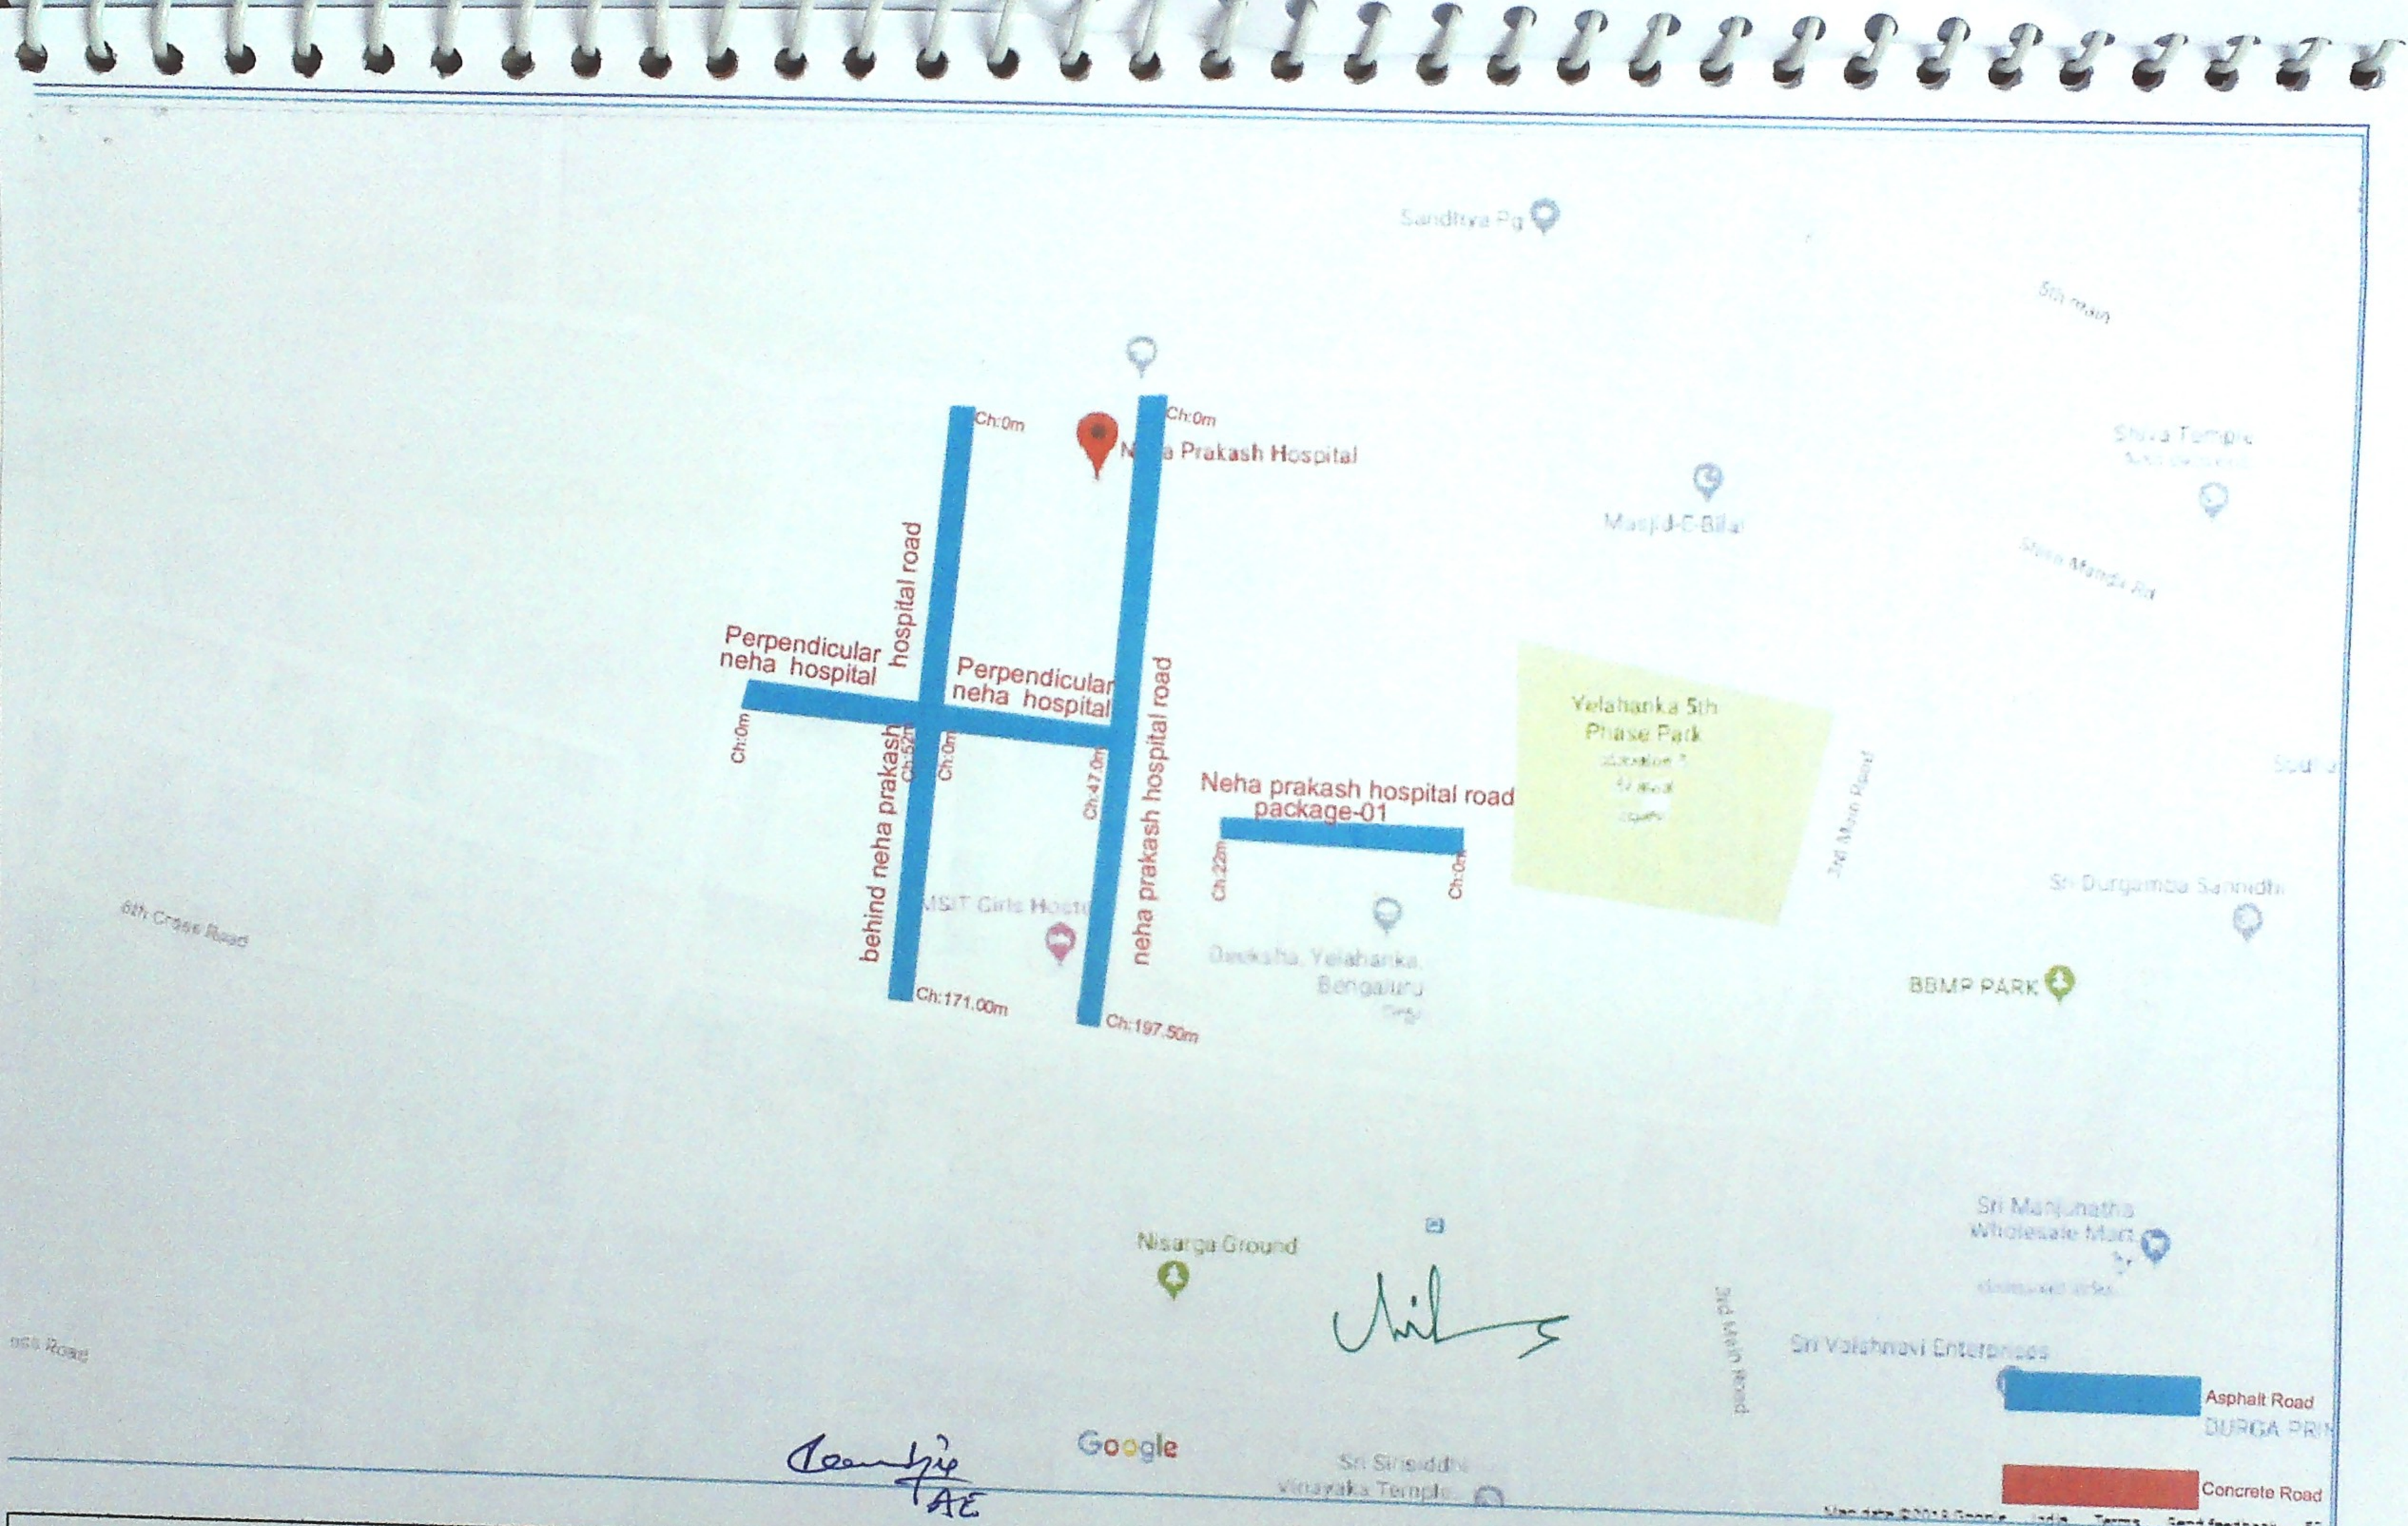

CLIENT: BRUHAT BANGALORE MAHANAGARA PALIKE	PACKAGE-2	Dwg Title: As Built plan	Scale; N.T.S Date

CLIENT: BRUHAT BANGALORE MAHANAGARA PALIKE	PACKAGE-2	Dwg Title: As Built plan	scale; N.T.S Date

CLIENT:		Dwg Title:	Scale; N.T.S
BRUHAT BANGALORE MAHANAGARA PALIKE	PACKAGE-3	As Built plan Dwg no:	Date

Someswara Temple
ಸೋಮೇಶ್ವರ
ದೇವಸ್ಥಾನ

Rainbow School
Of Musi

chikkabommasandra
Someshwara nagara

Harihara Stores

Main Ro

3rd Main road
Ch:0m

4th B cross
Ch:182m

3rd B cross
Ch:0m
Ch:186m

1 crs
Ch:0m
Ch:25m

2 crs
Ch:31m

3 crs
Ch:0m
Ch:108m

4crs
Ch:0m
Ch:33m

3rd Main road
Ch:0m

2nd B cross
Ch:68.80m

TA Cross Rd

Asphalt Road

Concrete Road

CLIENT: BRUHAT BANGALORE MAHANAGARA PALIKE	PACKAGE-3	Dwg Title: As Built plan	scale; N.T.S Date
		Dwg no:	

Secure https://www.google.co.in/maps/dir///@13.098414,77.5810772,17z/data=!4m2!4m1!3e2

ps.html

CLIENT: BRUHAT BANGALORE MAHANAGARA PALIKE	PACKAGE-3	Dwg Title: As Built plan
		scale; N.T.S
		Date
		Dwg no:

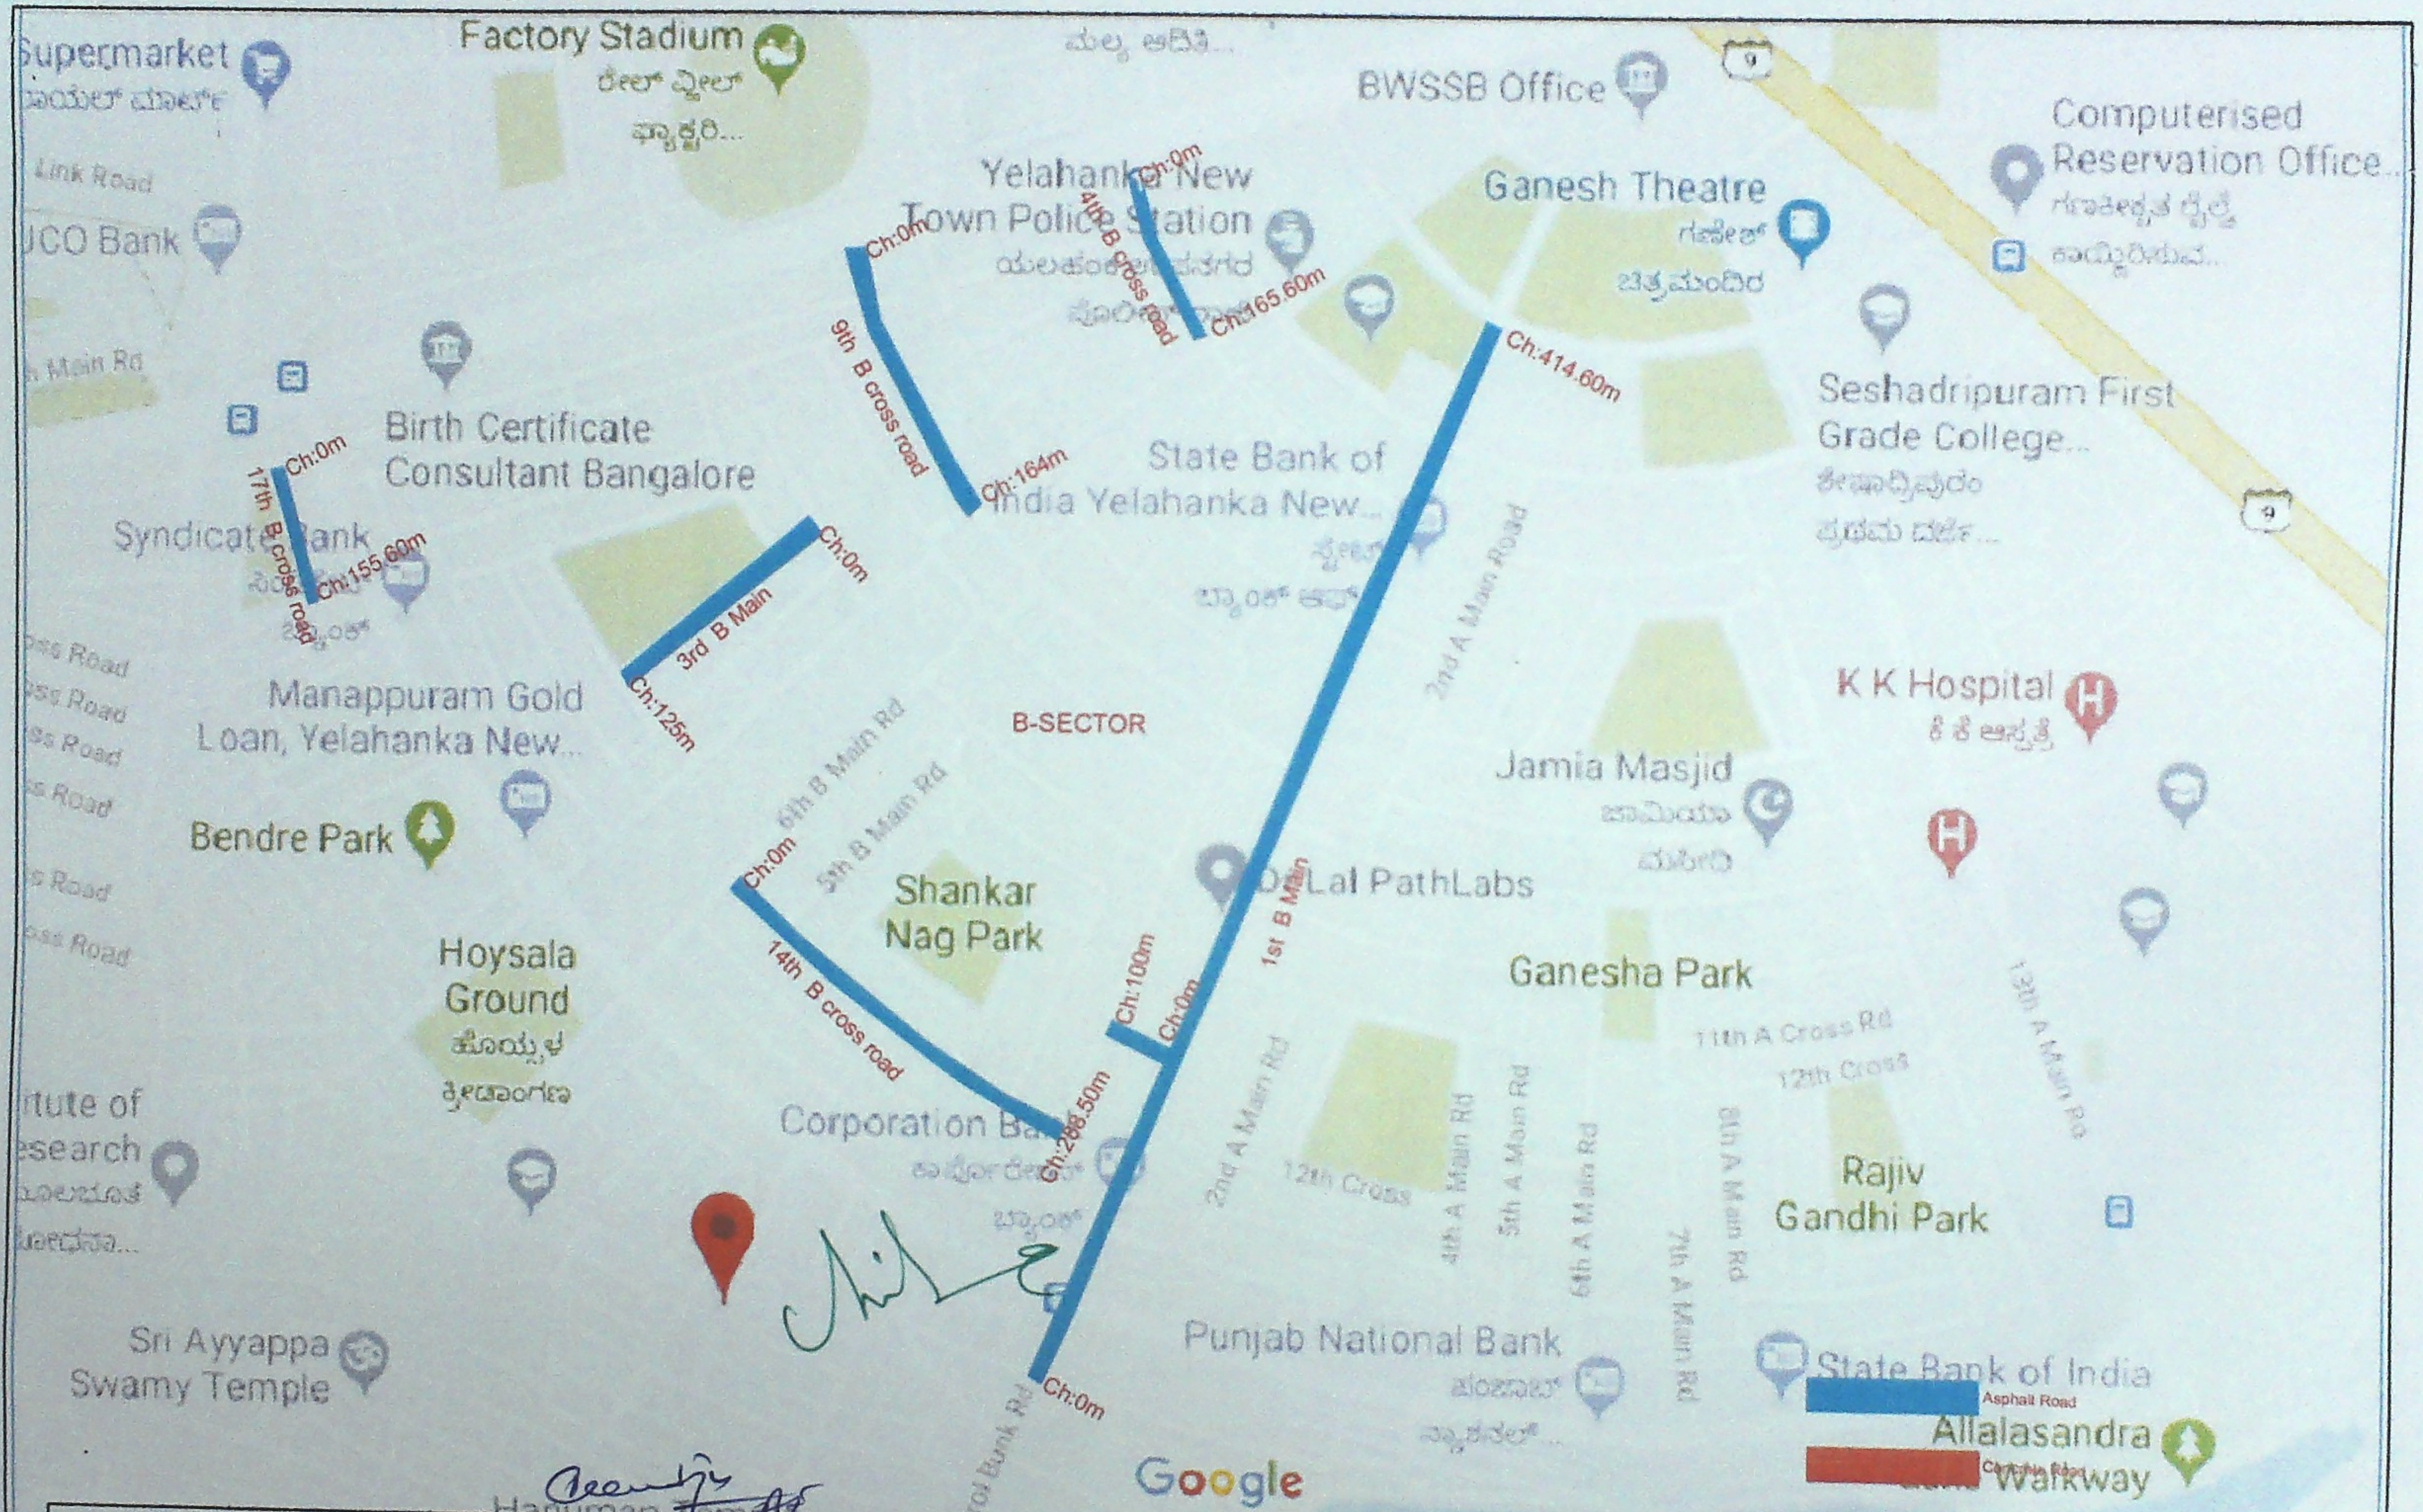

CLIENT: BRUHAT BANGALORE MAHANAGARA PALIKE	PACKAGE-3	Dwg Title: As Built plan Dwg no:
		Scale; N.T.S Date

CLIENT: BRUHAT BANGALORE MAHANAGARA PALIKE	PACKAGE-3	Dwg Title: As Built plan Dwg no:
		scale; N.T.S Date Rev. R0

Sai Baba Temple

Aster Park

1st Cross Road

2nd Cross Road

4th Cross Road

11th B

Ch:242.00m

3rd cross road

Ch:0m

1st Main Road

Ch:158.70m

5th cross road

Ch:0m

Mathru layout

Ch:349.60m

7th cross road

6th Cross Road

1st Main Road

Ch:0m

The Reader

Asphalt Road

Concrete Road

Maternity Hospital

CLIENT: BRUHAT BANGALORE MAHANAGARA PALIKE	PACKAGE-4	Dwg Title: As Built plan	Scale; N.T.S
			Date
		Dwg no:	Rev; R0

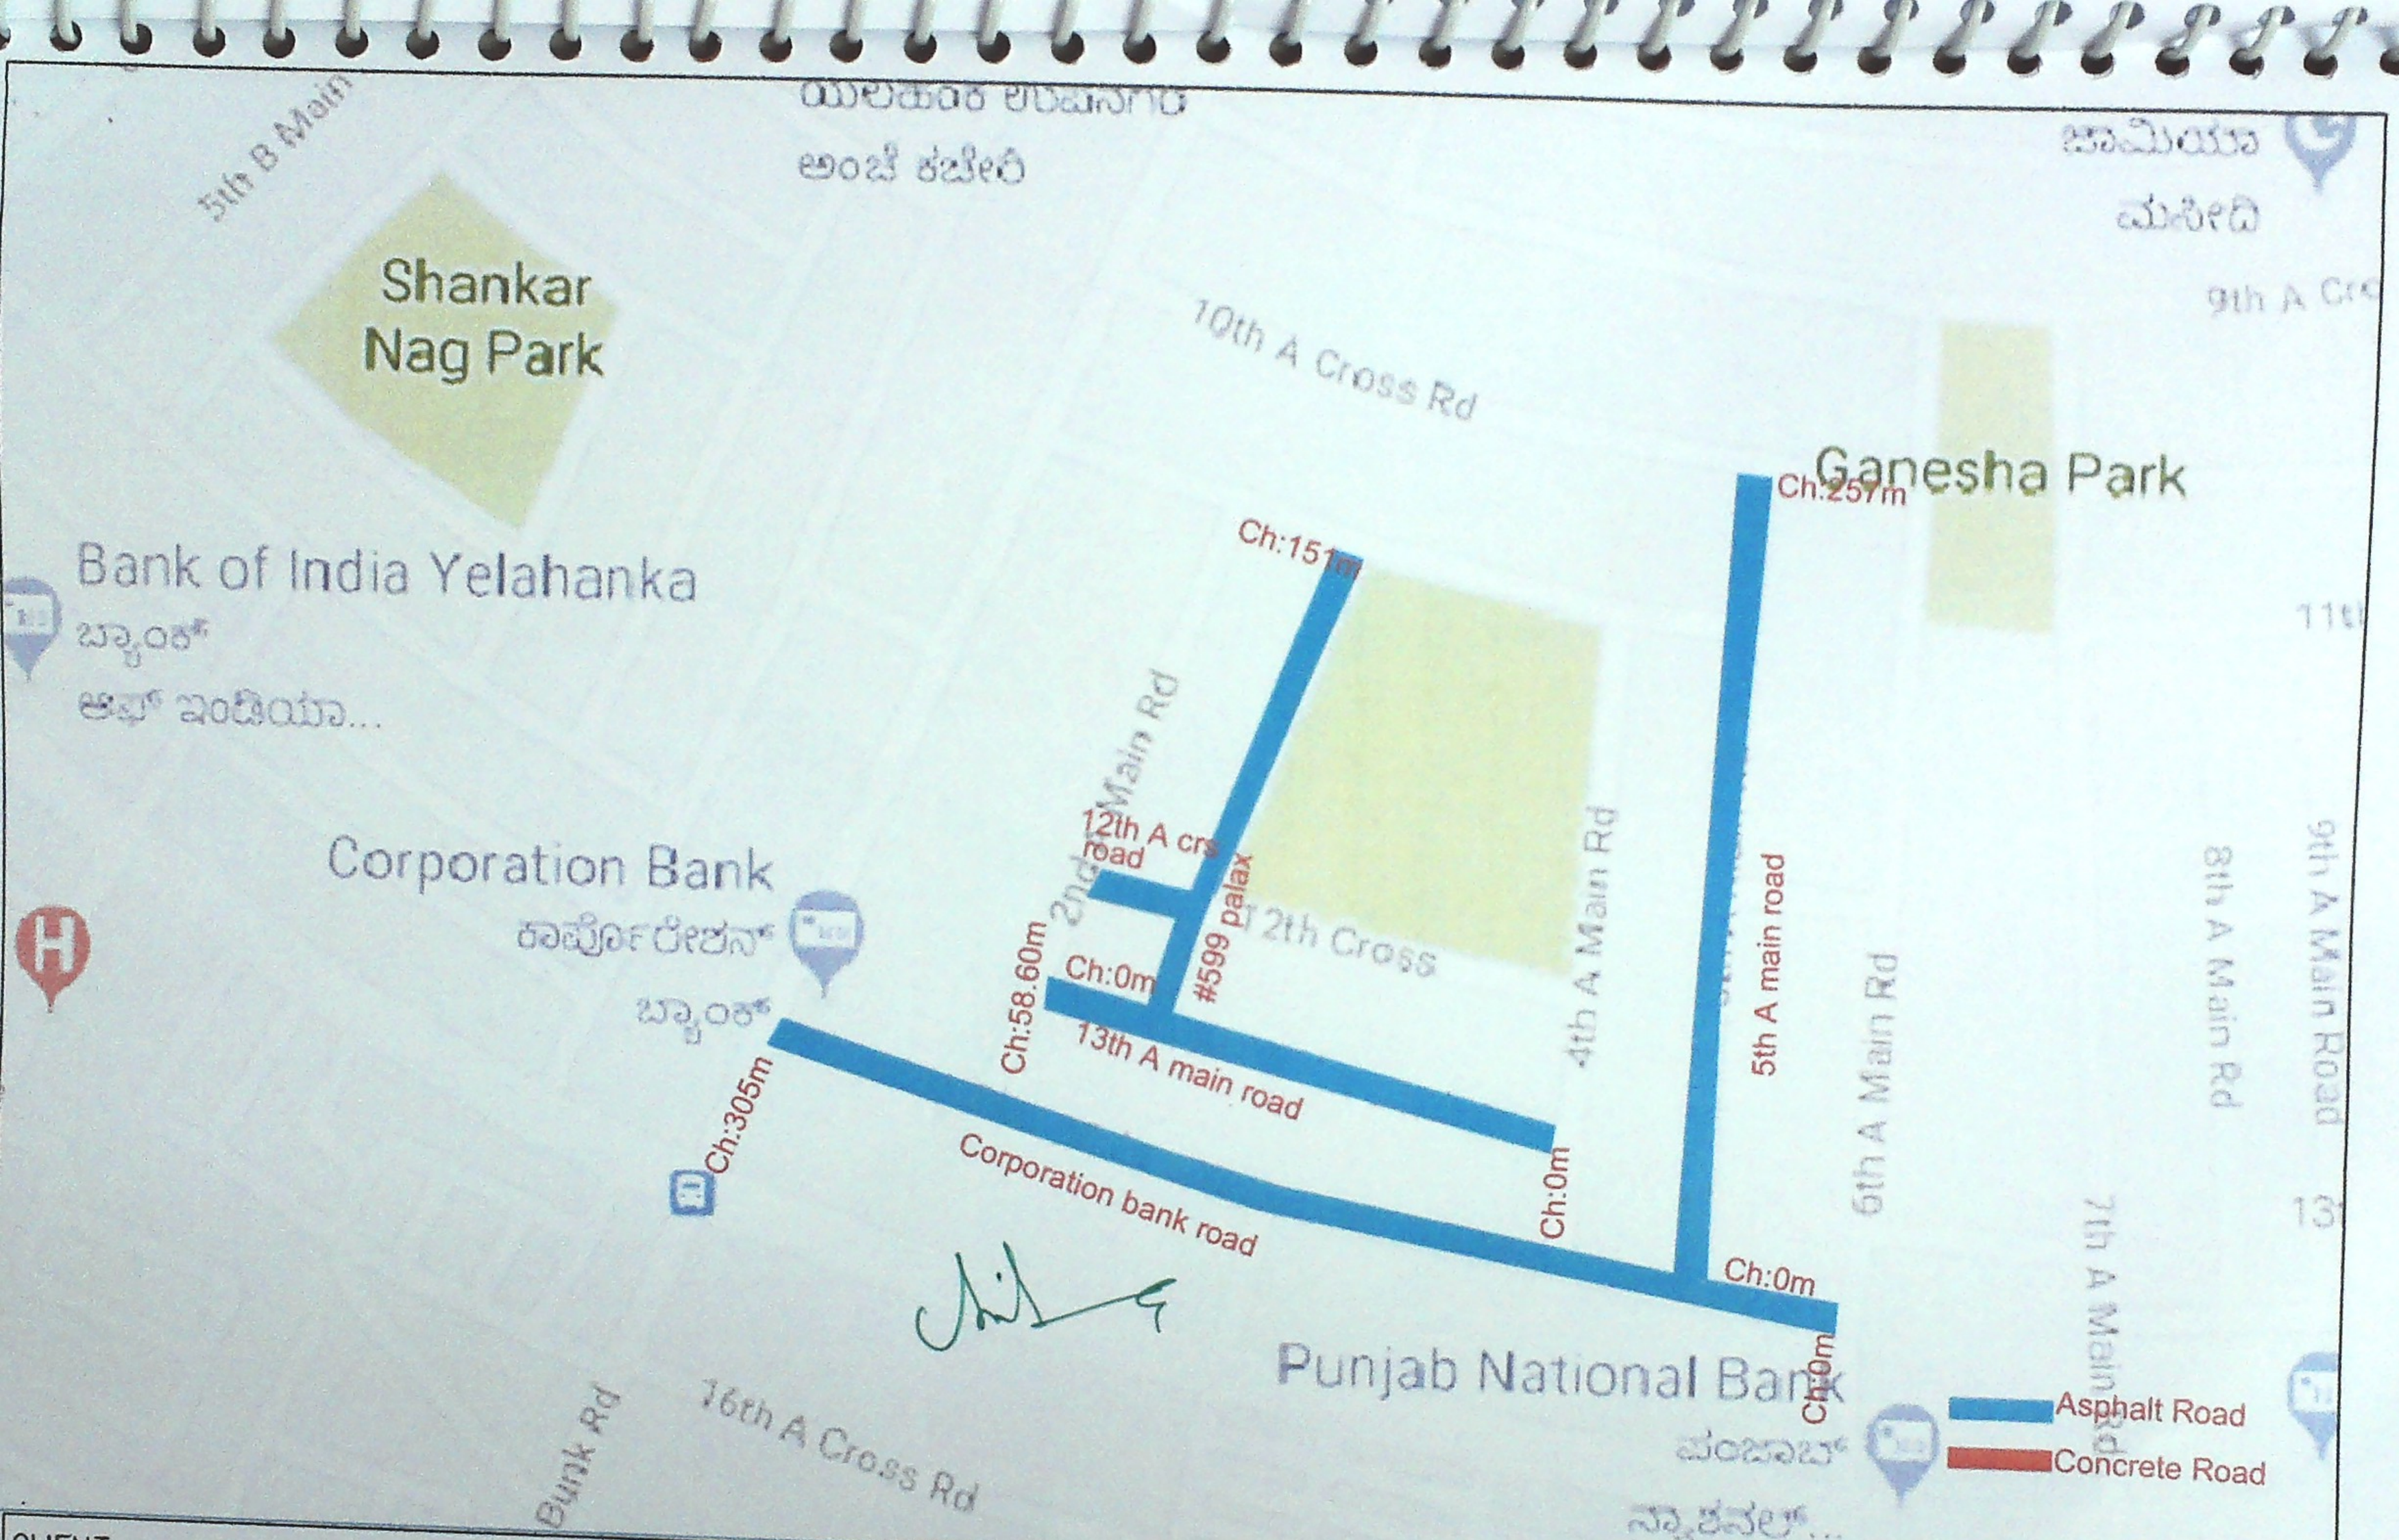

CLIENT: BRUHAT BANGALORE MAHANAGARA PALIKE	PACKAGE-4	Dwg Title: As Built plan	scale; N.T.S
			Date
		Dwg no:	Rev: R0

WEAR
TIONS

CLIENT: BRUHAT BANGALORE MAHANAGARA PALIKE	PACKAGE-4	Dwg Title: As Built plan Scale; N.T.S Date Dwg no:

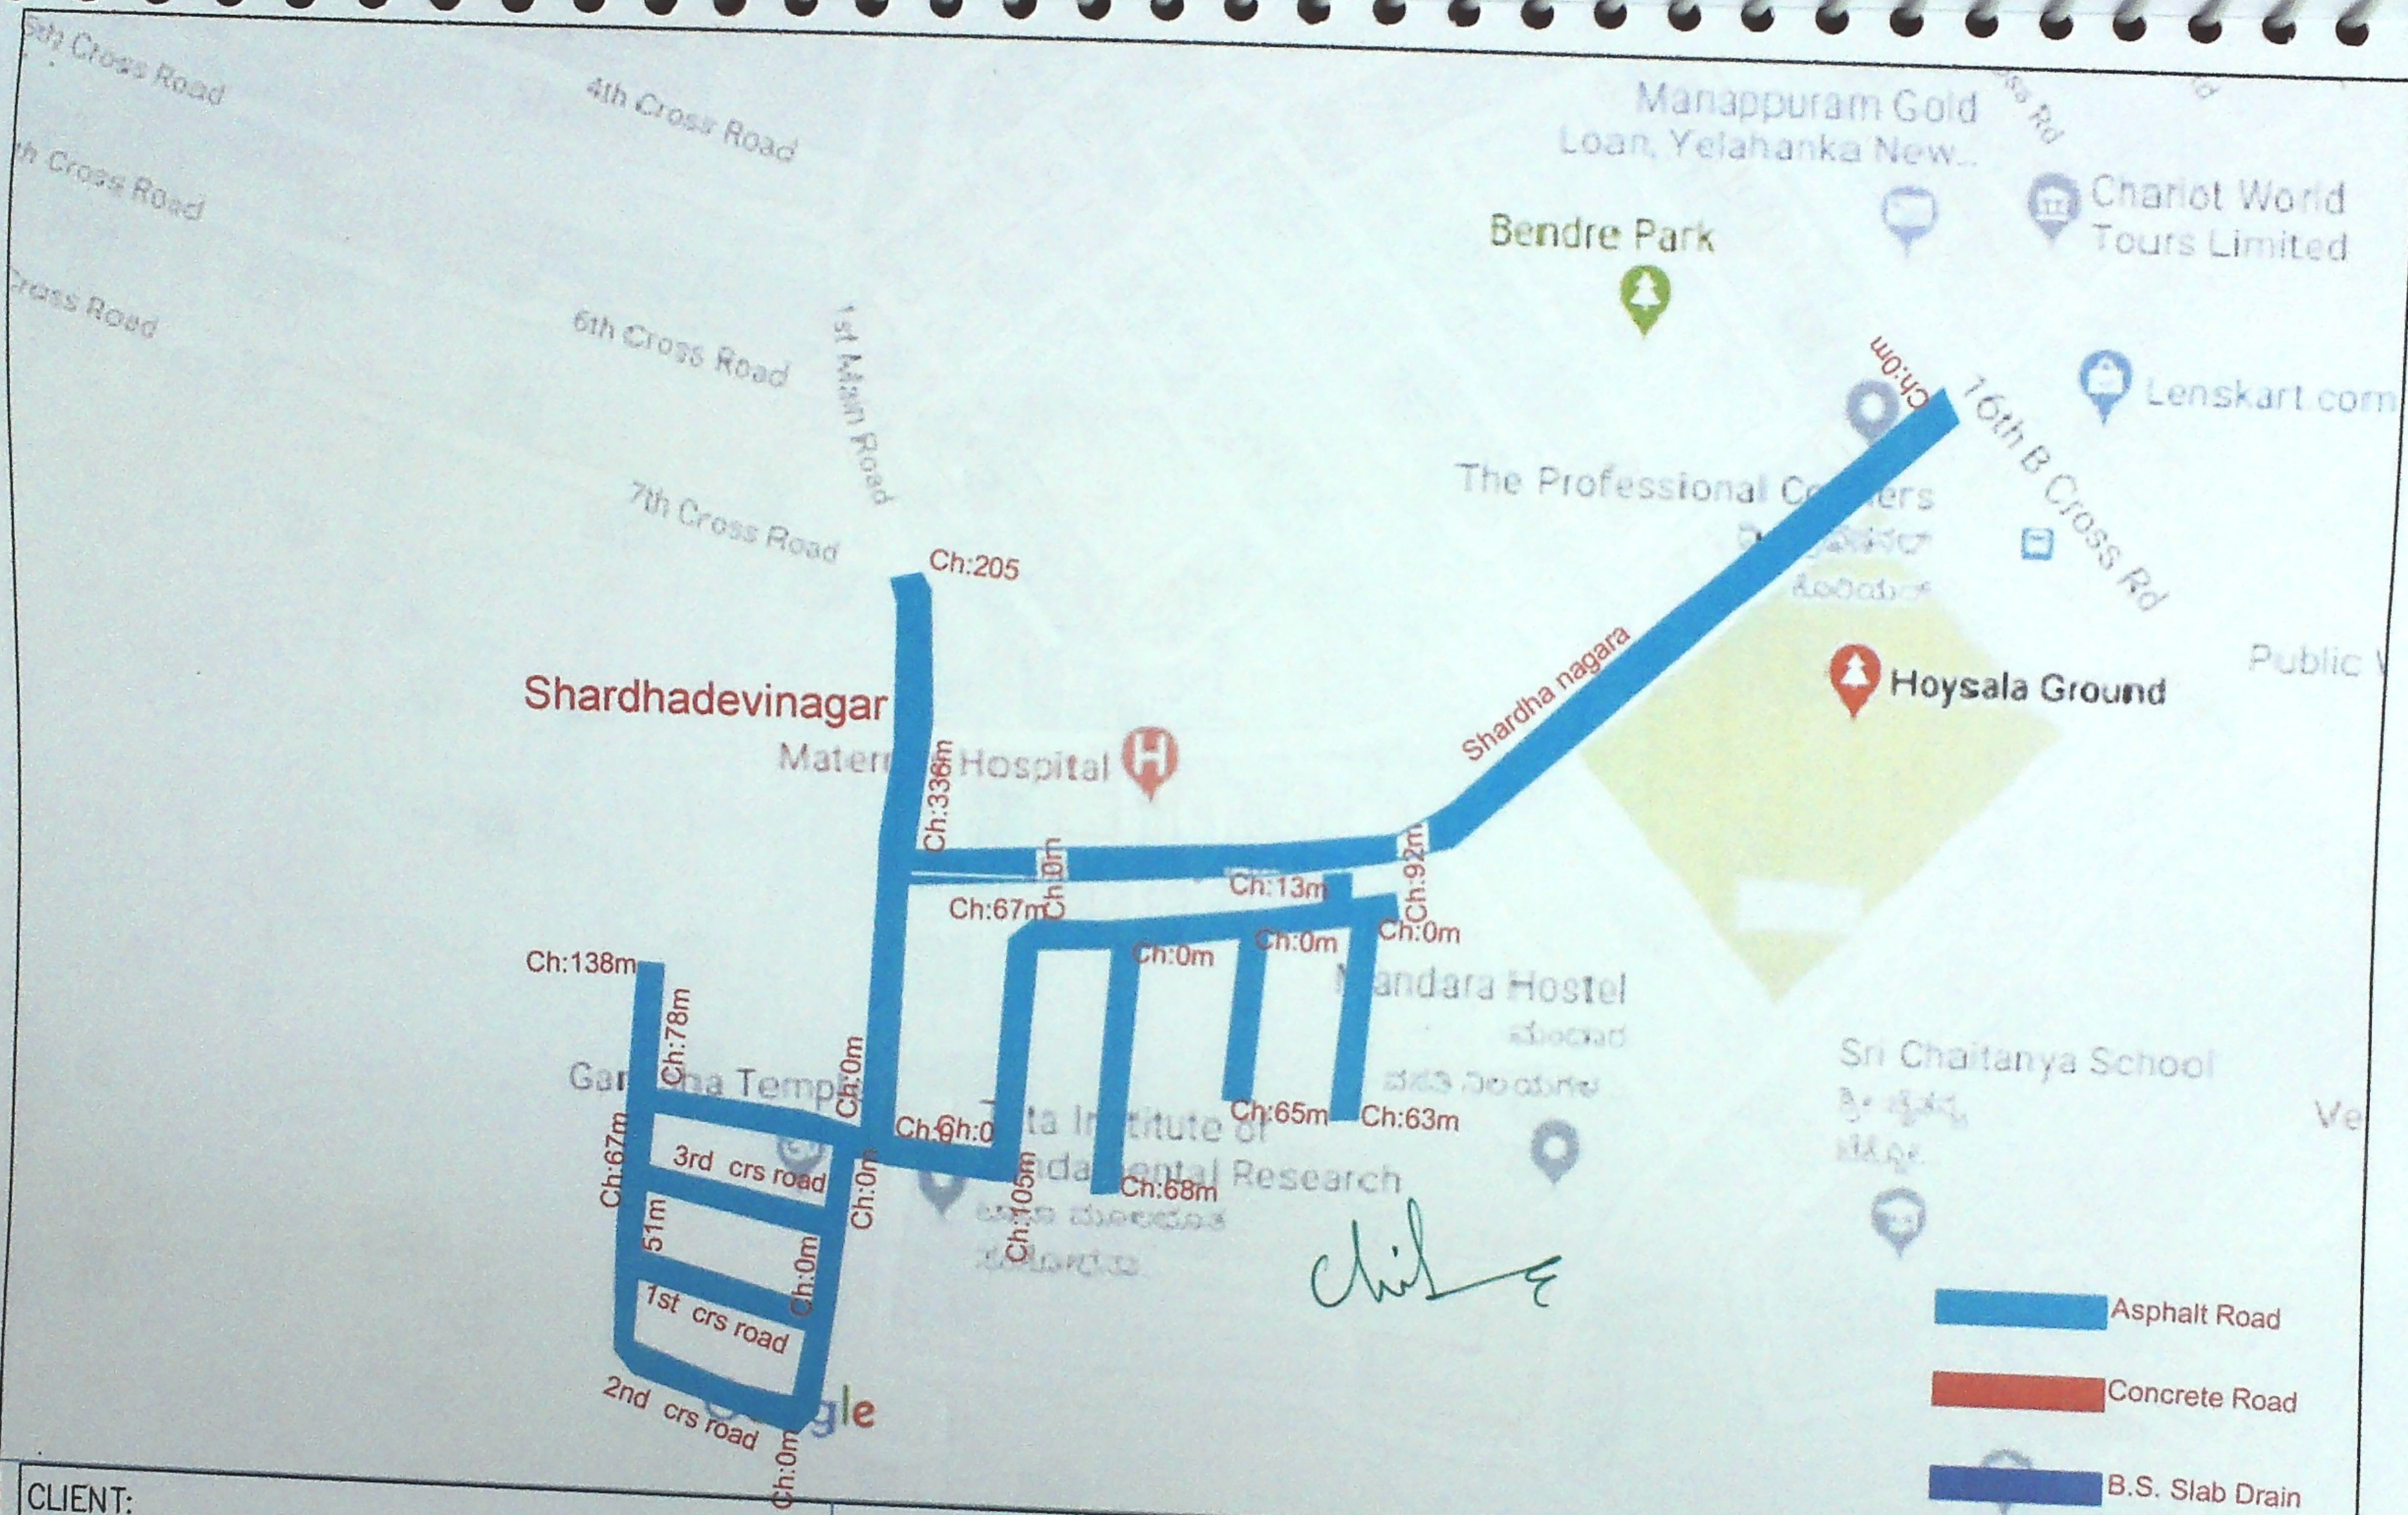

CLIENT: BRUHAT BANGALORE MAHANAGARA PALIKE	PACKAGE-4	Dwg Title: As Built plan Scale; N.T.S Date Dwg no:

CLIENT: BRUHAT BANGALORE MAHANAGARA PALIKE	PACKAGE-4	Dwg Title: As Built plan	scale; N.T.S
			Date
		Dwg no:	Rev: R0